


A	RELATIONSHANDLING	2008-03-19	OW
BET	ANT	ÄNDRINGEN AVSER	DATUM
			SIGN



RELATIONSHANDLING

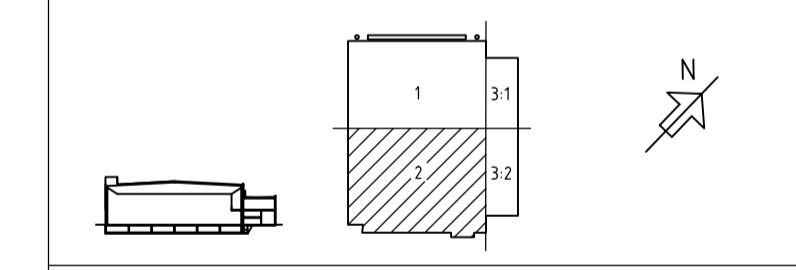


white
White arkitekter AB
Trädgårdsgatan 14
SE 702 12 Örebro
tel +46(0)19-6702200
fax +46(0)19-6702222
www.white.se

A	WHITE ARKITEKTER AB	TEL 019 - 670 22 00	FAX 019 - 670 22 22
K	WSP BYGGPROJEKTERING	TEL 019 - 17 89 50	FAX 019 - 13 32 00
V	ÄF INFRASTRUKTUR AB	TEL 019 - 601 46 00	FAX 019 - 611 45 92
W	RÖRPLANERING AB	TEL 019 - 472 14 40	
E	ÅKESSON ELTEKNIK AB	TEL 019 - 26 26 99	FAX 019 - 26 32 69
S1	ALBACON AB	TEL 031 - 706 89 20	FAX 031 - 706 89 21
S2	INGEMANSSONS TECHNOLOGY AB	TEL 08 - 709 20 00	FAX 08 - 709 20 10

UPPDRAG NR: 81 030100
RITAD/INSTR AV: SAX
ANSVARIG: SVEN GUNNARSON
DATUM: 2007-05-21

CONVENTUM, MASSHALL
KV. STINSEN 19, ÖREBRO

PLAN 3, DEL 2 (+17.26)
SKALA: A1: 1:100, A3: 1:200
NUMMER: A-40.1-1032
BET: A

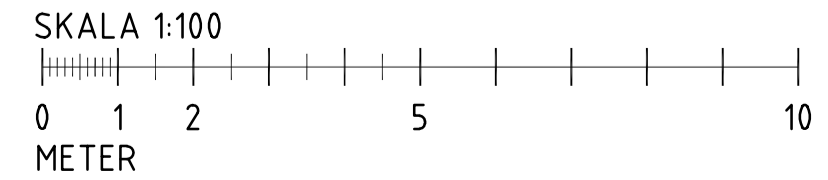

Modellförfattare: A
Filen: A-40.1-1032
Datum: 2008-03-07