



Modellversion
Filnam E6202
Datum 2008-05-07

Modellversion
Filnam A6202
Datum 2007-07-02

Externa referenser: \PMODELL\STAMPDVG \PMODELL\PM1_P1DVG \AMODELL\A40P02DVG \EMODELL\E61P02DVG \EMODELL\E61T01DVG

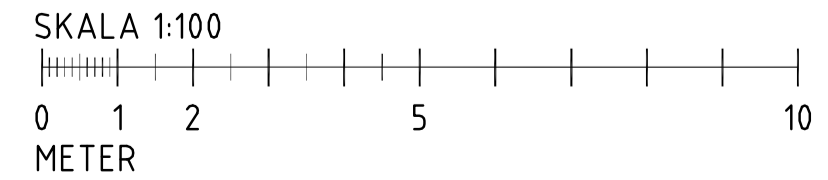

BET	ANT	ÄNDRINGEN AVSER	DATUM	SIGN
-----	-----	-----------------	-------	------

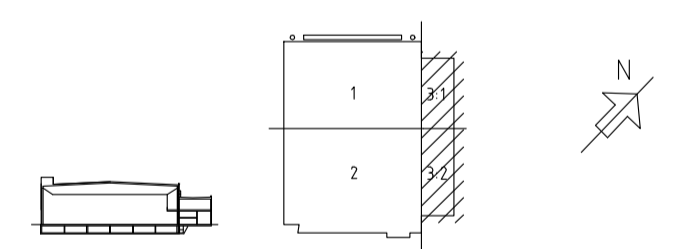

RELATIONSHANDLING 080507

ÖREBROPORTEN
Skapar rum för utveckling

Åkessons elteknik ab

Leif Åkessons elteknik ab Tunnilandsgatan 5, 2tr Box 1447, 701 14 Örebro
Telefon 019-26 26 99 Mobil 070-266 26 99 Telefax 019-26 32 69

A	WHITE ARKITEKTER AB	TEL 019 - 470 22 00	FAX 019 - 470 22 32
K	WSP BYGGPROJEKTERING	TEL 019 - 17 89 50	FAX 019 - 13 32 00
V	ÄF INFRASTRUKTUR AB	TEL 019 - 601 46 00	FAX 019 - 611 45 92
W	RÖRPLANERING AB	TEL 019 - 472 14 40	
E	ÅKESSON ELTEKNIK AB	TEL 019 - 26 26 99	FAX 019 - 26 32 69
S1	ALBAÇON AB	TEL 031 - 706 89 20	FAX 031 - 706 89 21
S2	INGEMANSSONS TECHNOLOGY AB	TEL 08 - 709 20 00	FAX 08 - 709 20 10

UPPRÅD NR	RITAD/KONSTR AV	HANDLAGGARE
0701-1	DC	L ÅKESSON
DATUM	ANSVARIG	
2007-05-11	LEIF ÅKESSON	

CONVENTUM, MASSHALL
KV. STINSEN 19, ÖREBRO

PLAN 2 - KRAFT

SKALA	NUMMER	BET
A1-1:100	E62-01-2013	
A3-1:200		