


A	RELATIONSHANDLING	2008-03-19	OW
BET	ANT	ÄNDRINGEN AVSER	DATUM SIGN



RELATIONSHANDLING

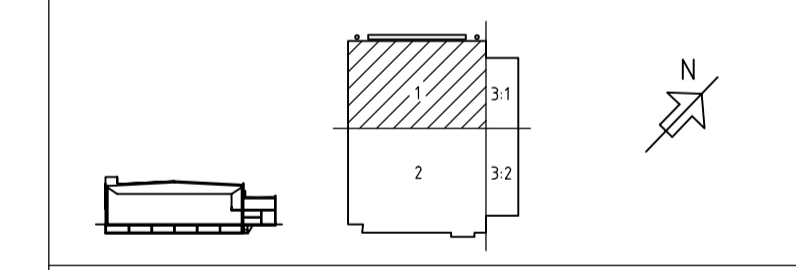


white
White arkitekter AB
Trädgårdsgatan 14
SE 702 12 Örebro
tel +46(0)19-6702200
fax +46(0)19-6702222
www.white.se

A	WHITE ARKITEKTER AB	TEL 019 - 670 22 00	FAX 019 - 670 22 22
K	WSP BYGGPROJEKTERING	TEL 019 - 17 89 50	FAX 019 - 13 32 00
V	ÅF INFRASTRUKTUR AB	TEL 019 - 601 46 00	FAX 019 - 611 45 92
W	RÖRPLANERING AB	TEL 019 - 472 14 43	
E	ÅKESSON ELTEKNIK AB	TEL 019 - 26 26 99	FAX 019 - 26 32 69
S1	ALBACON AB	TEL 031 - 706 89 20	FAX 031 - 706 89 21
S2	INGEMANSSONSSON TECHNOLOGY AB	TEL 08 - 709 20 00	FAX 08 - 709 20 10

UPPDRAG NR 81 030100
RITAD/KONSTR AV SAX
ANSVARIG SVEN GUNNARSON
DATUM 2007-05-21
HANDLÄGGARE
CONVENTUM, MASSHALL
KV. STINSEN 19, ÖREBRO

SKALA A1: 1:100 A3: 1:200	NUMMER A-40.1-1011	BET A
------------------------------	--------------------	-------

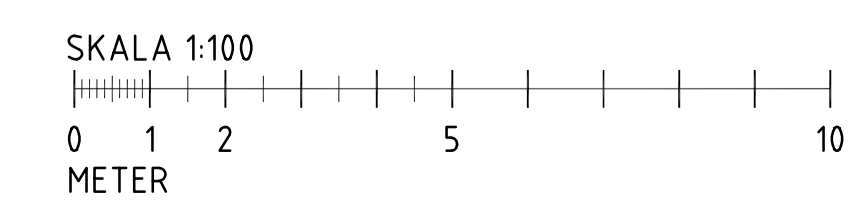

Modellförfattare: Mod.P01
Datum: 2007-05-21

PLO: 2008-05-27 16:48 R:\Conventum\030100\RELATIONSHANDLING\A1\bet\A401_1010.dwg 81ow