



Modellfilisversion
Filnamn: E62P06
Datum: 2008-05-07

Modellfilisversion
Filnamn: A62P06
Datum: 2007-07-02

REF
Externa referenser: \PMODELL\STAMPDWG \PMODELL\PM1_P1DWG \AMODELL\A40P06.DWG \EMODELL\E62P06.DWG \EMODELL\E62T01DWG

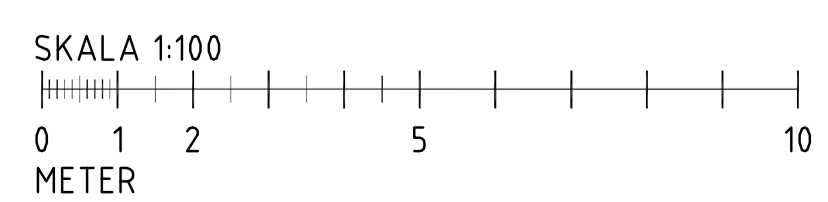

BET	ANT	ÄNDRINGEN AVSER	DATUM	SIGN

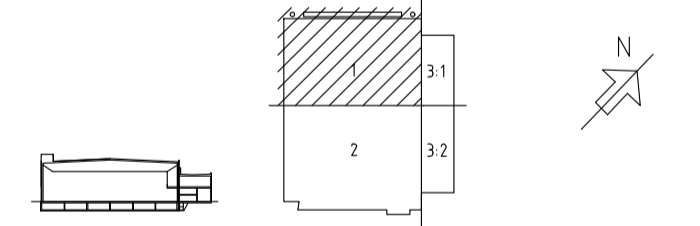

RELATIONSHANDLING 080507



Åkesson elteknik ab

Leif Åkesson elteknik ab Tunnländsgatan 5, 2tr Box 1447, 701 14 Örebro
Telefon 019-26 26 99 Mobil 070-086 26 99 Telefax 019-26 32 69

A	WHITE ARKITEKTER AB	TEL 019 - 470 22 00	FAX 019 - 470 22 32
K	WSP BYGGPROJEKTERING	TEL 019 - 17 89 50	FAX 019 - 13 32 00
V	ÅF INFRASTRUKTUR AB	TEL 019 - 60146 00	FAX 019 - 61145 92
W	RÖRPLANERING AB	TEL 019 - 472 14 40	
E	ÅKESSON ELTEKNIK AB	TEL 019 - 26 26 99	FAX 019 - 26 32 69
S1	ALBALCON AB	TEL 031 - 706 89 20	FAX 031 - 706 89 21
S2	INGEMANSSONSSON TECHNOLOGY AB	TEL 08 - 709 20 00	FAX 08 - 709 20 10

UPPRAG NR	RITAD/KONSTR AV	HANDLAGGARE
0701-1	DC	L ÅKESSON

DATUM: 2007-05-11
ANSVARIG: LEIF ÅKESSON

CONVENTUM, MASSHALL
KV. STINSEN 19, ÖREBRO
PLAN 6 - KRAFT
SKALA: A1: 1:100, A3: 1:200
NUMMER: E62-01-6011
BET: